



UPSTREAM ELEVATION
SCALE 4" = 1'-0"

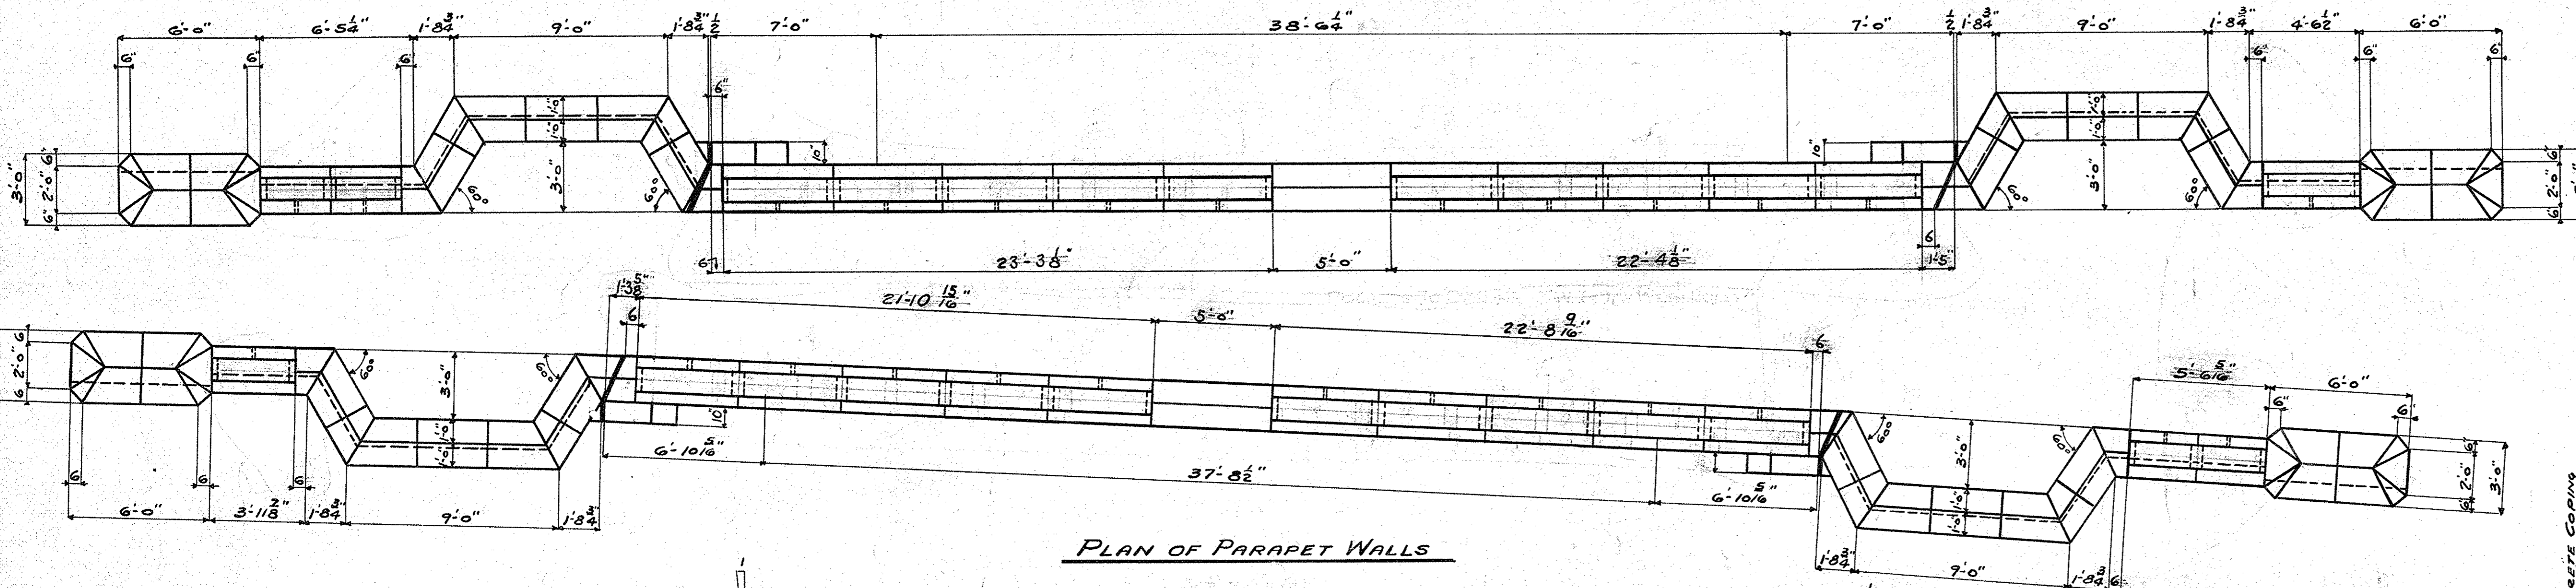

PLAN OF PARAPET WALLS

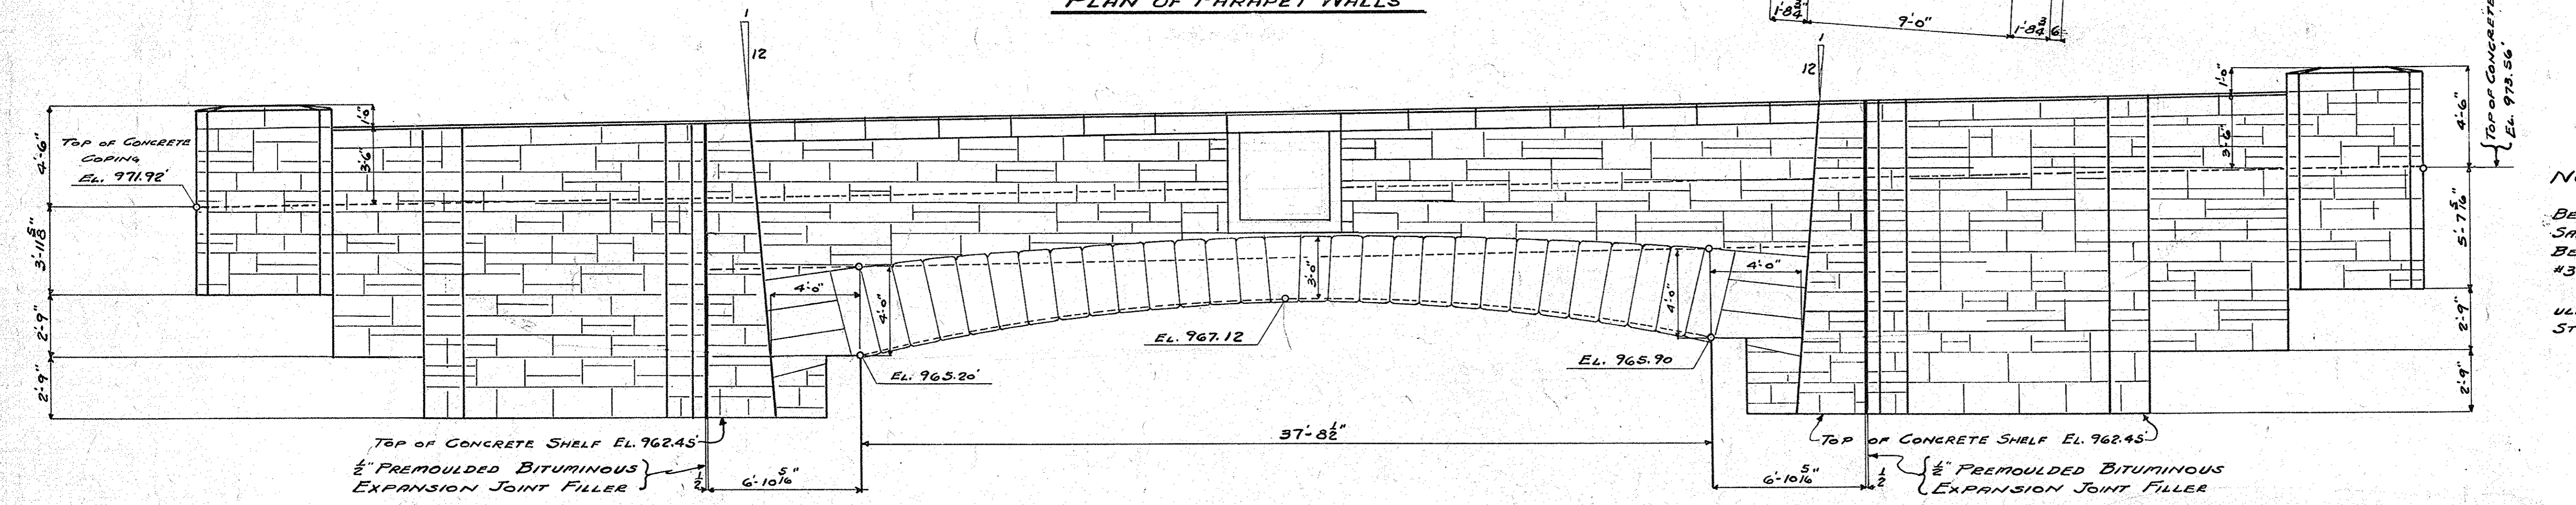

DOWNSTREAM ELEVATION

NOTES:
ALL SANDSTONE SHALL BE EQUAL IN QUALITY TO GOOD BEAVER VALLEY, BUTLER, LAWRENCE OR CLEARFIELD COUNTY SANDSTONE AND SHALL BE APPROVED BY THE DIRECTOR BEFORE USE. (SEE SUPPLEMENTAL SPECIFICATIONS, PARAGRAPH #3 SANDSTONE.)
STONE TO BE ROCKFACE WITH 1" BOW, Laid IN RECTANGULAR RANDOM, ASHLAR, ON ITS NATURAL BED, WITH 1/2" STRUCK MORTAR JOINTS.

Elevations, Dimensions and Details shown in red indicate structures as built

IN CHARGE	R.E. Olson	DRAWN	H.W. Tross	CHECKED	W.P. Thomas	11-15-35
REVISIONS						
NO.	ORDERED	MADE	DATE	CHECKED	REMARKS	
5-15	C.L.M.					

SUBMITTED JUNE 6, 1935
[Signature]
BRIDGE DESIGN ENGINEER
APPROVED
[Signature]
PLANNING ENGINEER

**COUNTY OF ALLEGHENY
PITTSBURGH, PA.**

**BABCOCK BOULEVARD
BRIDGE NO. 26
PINE CREEK**

NORTH PARK, M'CANDLESS TOWNSHIP
ELEVATIONS OF STONE FACING
SCALES AS SHOWN JUNE 6, 1935
SHEET 9 OF 10 SHEETS